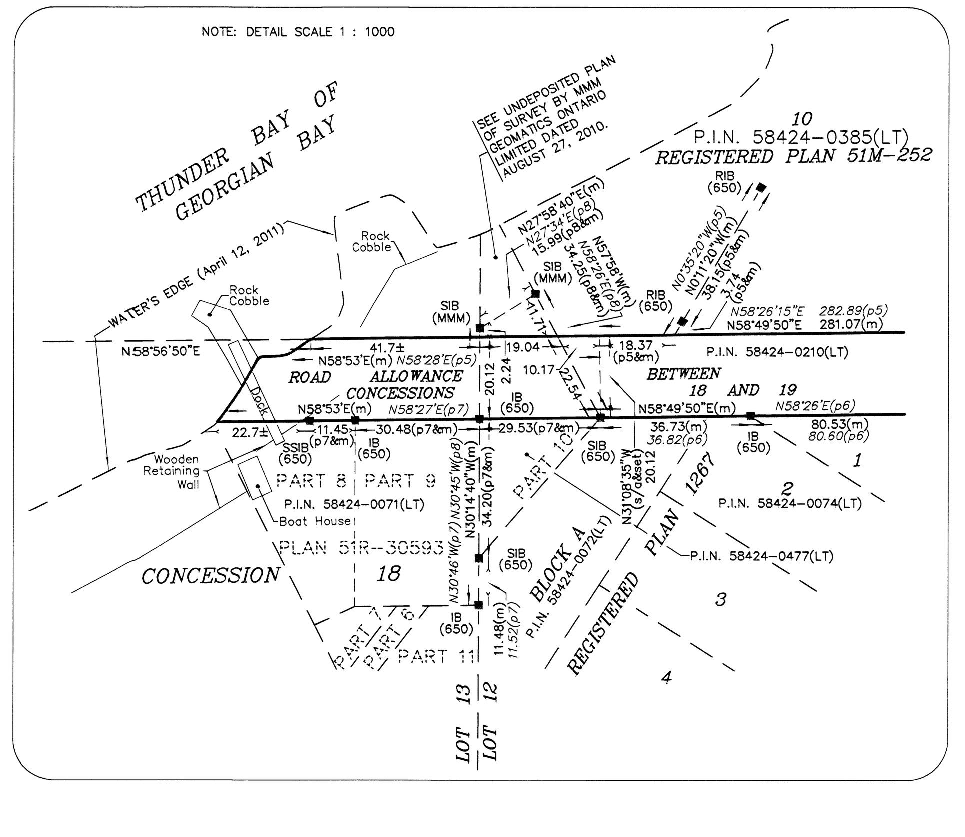

SURVEYOR'S CERTIFICATE

I CERTIFY THAT:

1. THIS SURVEY AND PLAN ARE CORRECT AND IN ACCORDANCE WITH THE SURVEYS ACT, THE SURVEYORS ACT AND THE LAND TITLES ACT AND THE REGULATIONS MADE UNDER THEM.
2. THE SURVEY WAS COMPLETED ON THE 11TH DAY OF MAY, 2011.
3. THIS PLAN AND FIELD NOTES WAS PREPARED FROM AN ACTUAL SURVEY PERFORMED UNDER MY PERSONAL SUPERVISION AND I WAS PRESENT ON THE SITE DURING THE PROGRESS OF THIS SURVEY.

September 25th 2013 — DATE

JOHN F. GOLTZ
ONTARIO LAND SURVEYOR

LEGEND AND NOTES

⊟	DENOTES	MONUMENT PLANTED
■	DENOTES	MONUMENT FOUND
IB	DENOTES	IRON BAR
SIB	DENOTES	STANDARD IRON BAR
SSIB	DENOTES	SHORT STANDARD IRON BAR
RPL	DENOTES	ROCK PLUG
RIB	DENOTES	ROUND IRON BAR
ACC.	DENOTES	ACCEPTED
FD.	DENOTES	FOUND
(m)	DENOTES	MEASURED
(p)	DENOTES	PLAN 51R-11404
(p2)	DENOTES	PLAN 51R-13426
(p3)	DENOTES	PLAN 51R-31682
(p4)	DENOTES	PLAN 51R-12932
(p5)	DENOTES	REGISTERED PLAN 51M-252
(p6)	DENOTES	REGISTERED PLAN 1267
(p7)	DENOTES	PLAN 51R-30593
(p8)	DENOTES	UNDEPOSITED PLAN OF SURVEY BY MMM GEOMATICS ONTARIO LIMITED DATED AUGUST 27, 2010.
(650)	DENOTES	C.P. O'DALE, OLS
(877)	DENOTES	W.JACKSON, OLS
(1094)	DENOTES	J.W. NICHOLSON, OLS
(1328)	DENOTES	H.L. MELLISH, OLS
(MMM)	DENOTES	MMM GEOMATICS ONTARIO LIMITED
(OU)	DENOTES	ORIGIN UNKNOWN
(s/a)	DENOTES	SPLIT ANGLE
P.W.F.	DENOTES	POST AND WIRE FENCE
Tab	DENOTES	REFERS TO TABS APPENDED TO REPORT OF SURVEY BY JOHN F. GOLTZ, OLS DATED AUGUST 30, 2011.

DISTANCES SHOWN ON THIS PLAN ARE GROUND DISTANCES AND CAN BE CONVERTED TO GRID DISTANCES BY MULTIPLYING BY A COMBINED SCALE FACTOR OF 0.999898

BEARINGS SHOWN ON THIS PLAN ARE MTM GRID BEARINGS, DERIVED FROM OBSERVED REFERENCE POINTS A AND B, SHOWN HEREON, BY REAL TIME NETWORK (RTN) OBSERVATIONS, AND ARE REFERRED TO THE CENTRAL MERIDIAN OF MTM ZONE 10, (79° 30' WEST LONGITUDE) NAD83 (CSRS) (1997.0)

OBSERVED REFERENCE POINTS (ORP's) DERIVED FROM GPS OBSERVATIONS USING REAL TIME NETWORK (RTN) SERVICE.
MTM ZONE 10, NAD83 (CSRS) (1997.0)

COORDINATES TO RURAL ACCURACY PER SEC. 14 (2) OF O.REG. 216/10

POINT ID	NORTHING	EASTING
ORP 'A'	4962960.53	261769.06
ORP 'B'	4964176.70	263783.70

COORDINATES CANNOT, IN THEMSELVES, BE USED TO RE-ESTABLISH CORNERS OR BOUNDARIES SHOWN ON THIS PLAN

PLAN AND FIELD NOTES OF THE RETRACEMENT SURVEY OF PART OF THE ROAD ALLOWANCE BETWEEN CONCESSIONS 18 AND 19 ACROSS LOTS 9, 10, 11, 12 & 13 GEOGRAPHIC TOWNSHIP OF TINY

NOW IN THE MUNICIPAL TOWNSHIP OF TINY

COUNTY OF SIMCOE

McINTOSH PERRY SURVEYING INC.

SCALE 1 : 2000

0 50 100 150 200 Metres

METRIC :

DISTANCES AND COORDINATES SHOWN ON THIS PLAN ARE IN METRES AND CAN BE CONVERTED TO FEET BY DIVIDING BY 0.3048.

PLAN ....

I HEREBY CERTIFY THAT THIS PLAN .... IS REGISTERED IN THE LAND REGISTRY OFFICE FOR THE LAND TITLES DIVISION OF SIMCOE (N° 51) AT .... O'CLOCK, ON THE .... DAY OF .... 2013.

REPRESENTATIVE FOR THE LAND REGISTRAR

PLAN MS-883

SURVEYED UNDER INSTRUCTIONS ISSUED MARCH 16, 2011 AND RECORDED IN THE OFFICE OF THE SURVEYOR GENERAL, MINISTRY OF NATURAL RESOURCES AT PETERBOROUGH, THIS .... DAY OF ...., 2013, AS MUN SUR 883.

Susan F. MacGREGOR
SURVEYOR GENERAL

THIS PLAN AFFECTS THE FOLLOWING P.I.N.'s 58424-0071(LT), 58424-0072(LT), 58424-0073(LT), 58424-0074(LT), 58424-0096(LT), 58424-0099(LT), 58424-0106(LT), 58424-0124(LT), 58424-0125(LT), 58424-0174(LT), 58424-0180(LT), 58424-0182(LT), 58424-0185(LT), 58424-0187(LT), 58424-0188(LT), 58424-0189(LT), 58424-0193(LT), 58424-0195(LT), 58424-0196(LT), 58424-0197(LT), 58424-0199(LT), 58424-C210(LT), 58424-0385(LT), 58424-0386(LT), 58424-0387(LT), 58424-0477(LT) AND 74037-0079(LT).

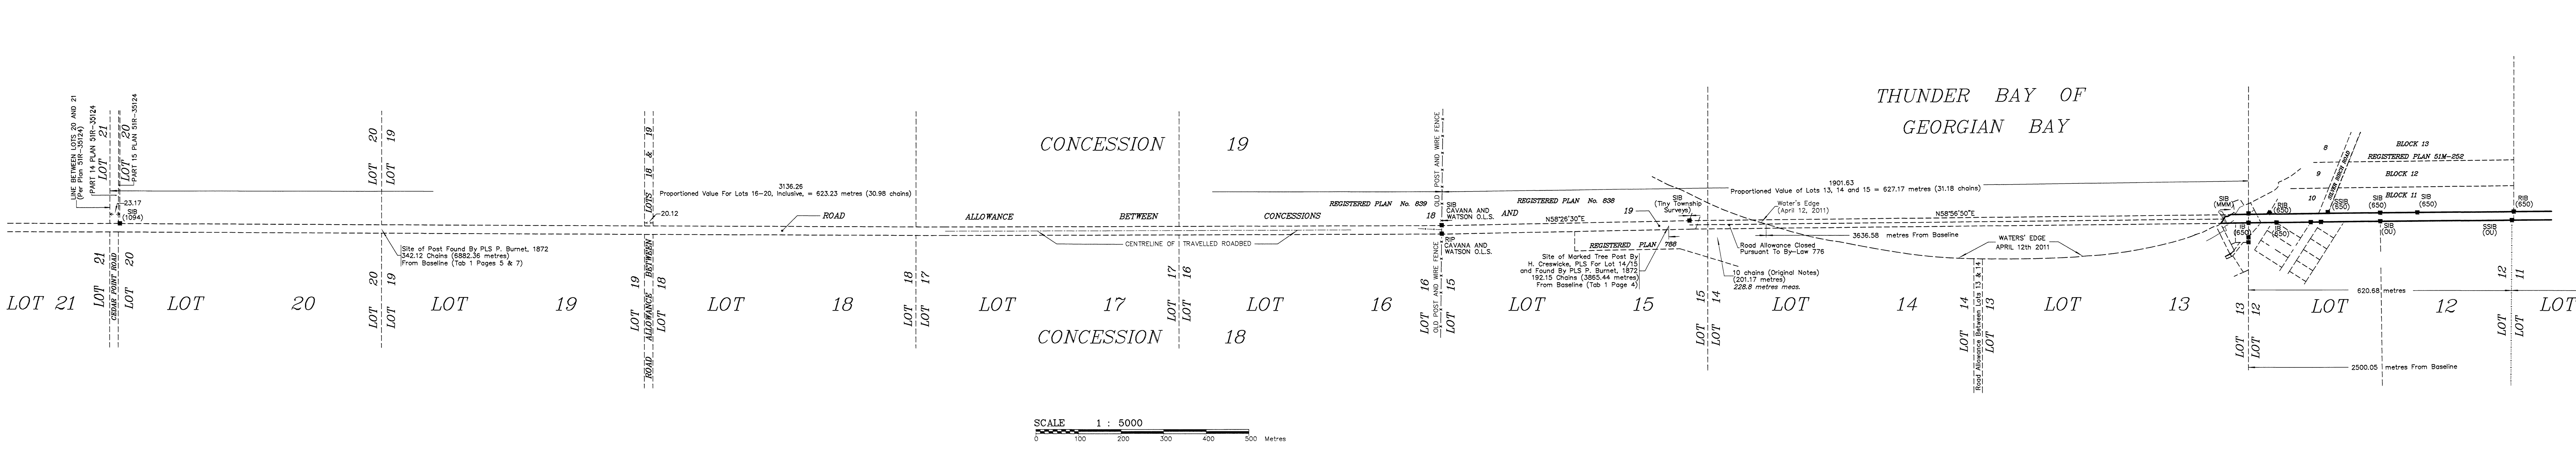

CONFIRMATION CERTIFICATE

UNDER THE POWERS CONFERRED UPON THE MINISTER OF NATURAL RESOURCES BY SECTION 48 (2) OF THE SURVEYS ACT R.S.O. 1990, CHAPTER S. 30, DELEGATED TO THE SURVEYOR GENERAL IN ACCORDANCE WITH SECTION 7 (1) OF THE MINISTRY OF NATURAL RESOURCES ACT, R.S.O. 1990, CHAPTER M. 31, I HEREBY CONFIRM THE POSITION OF THE ROAD ALLOWANCE BETWEEN CONCESSIONS 18 AND 19, ACROSS LOTS 9, 10, 11, 12 AND PART OF LOT 13, GEOGRAPHIC TOWNSHIP OF TINY, COUNTY OF SIMCOE, AS ILLUSTRATED ON THIS PLAN.

DATED AT PETERBOROUGH, ONTARIO
THIS THE 24th DAY OF October, 2013.

SUSAN F. MacGREGOR
SURVEYOR GENERAL

JOB No. 11-069 DRAWING #P11-069-2
THIS PLAN WAS PREPARED FOR: MINISTRY OF NATURAL RESOURCES

McINTOSH PERRY Surveying Inc.
3240 Drummond Con. 5A
R.R. #7
Perth, Ont.
K7H 3C9
Tel.: 613 267 6524
Fax: 613 267 7992

EXAMINED: JFG. PLAN CHECK: D.L.